


1	2	3	4	5	6	7	8												
 MAKE OF MATERIAL <table border="1"> <thead> <tr> <th>SR. NO.</th> <th>DESCRIPTION</th> <th>MAKE</th> </tr> </thead> <tbody> <tr> <td>01</td> <td>63A TP MCB</td> <td>SCHNEIDER</td> </tr> <tr> <td>02</td> <td>POWER & CONTROL TERMINALS</td> <td>CONNECTWELL</td> </tr> <tr> <td>03</td> <td>CONTACTOR</td> <td>SCHNEIDER</td> </tr> </tbody> </table> NOTES - PANEL SHALL BE WALL / SKID MOUNTING, 18 SWG THICK MS CRCA POWDER COATED - CABLE ENTRY FROM BOTTOM.								SR. NO.	DESCRIPTION	MAKE	01	63A TP MCB	SCHNEIDER	02	POWER & CONTROL TERMINALS	CONNECTWELL	03	CONTACTOR	SCHNEIDER
SR. NO.	DESCRIPTION	MAKE																	
01	63A TP MCB	SCHNEIDER																	
02	POWER & CONTROL TERMINALS	CONNECTWELL																	
03	CONTACTOR	SCHNEIDER																	
AS BUILT																			
APPR.			CLIENT –			MFD– Aster Tech.													
DRN		REV– 0	PROJECT –			TITLE – G.A. DIAGRAM													
CHD	V.K.	SUB.DT– 01.07.24	DATE– 01.07.24	SCALE– NTS	DRG.NO. NXT 33 BOTH PUMP WORKING STANDBY AUTOCHANGEOVER SHEET 1 OF 4														

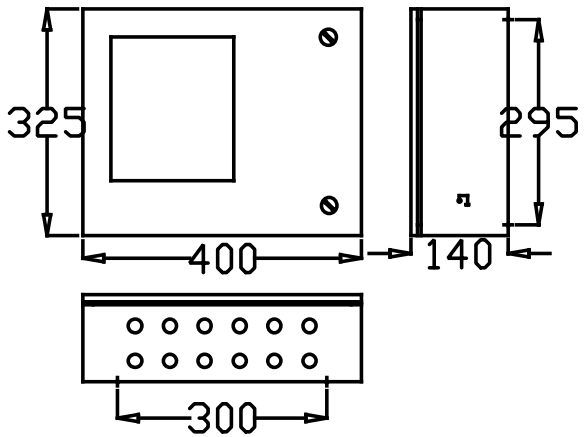

Workshop: 14-15, Panchratna Industrial Estate, Opp Satyam Mall, Sumip Composite-3 Lane, B/h VR Pilsulfate, Changodar-382213
Office: B-214, Nilkanth Palace, 100 feet Anandnagar Road, Satelite, Ahmedabad-380015
Phone: 9227418504/7227061661 | Email: sales@fiplco.com | Website: www.fiplco.com